



**ENERGY FIJI LIMITED**

# **BIDDING DOCUMENT**

---

**QELELOA 11kV/33kV SUBSTATION EXTENSION**

**TENDER NO: MR 350/2024**


**REVISION NOTES:**


| Date     | Notes                             | Prepared By | Rev No. |
|----------|-----------------------------------|-------------|---------|
| 29/11/24 | Addendum No.2 compiled and issued | Ram Maharaj | 3       |
|          |                                   |             |         |
|          |                                   |             |         |
# **ADDENDUM No. 2**

| <b>No</b> | <b>Description</b>   |
|-----------|--|
| 1         | <p>Section 9 – Single Line – Diagram &amp; Site Drawings</p> <p>Add<br/><i>“General Layout, Foundation Frame and Panel Section View of 33kV Switchgear”</i> refer Appendix 1.</p> <p><b>Note – For information only.</b></p>                                 |
| 2         | <p>Section 9 – Single Line – Diagram &amp; Site Drawings</p> <p>Add<br/><i>“Front General Arrangement &amp; Foundation Plan and Gross Sectional General Arrangement of 11kV Switchgear”</i> refer Appendix 2.</p> <p><b>Note – For information only.</b></p> |

APPENDIX 1

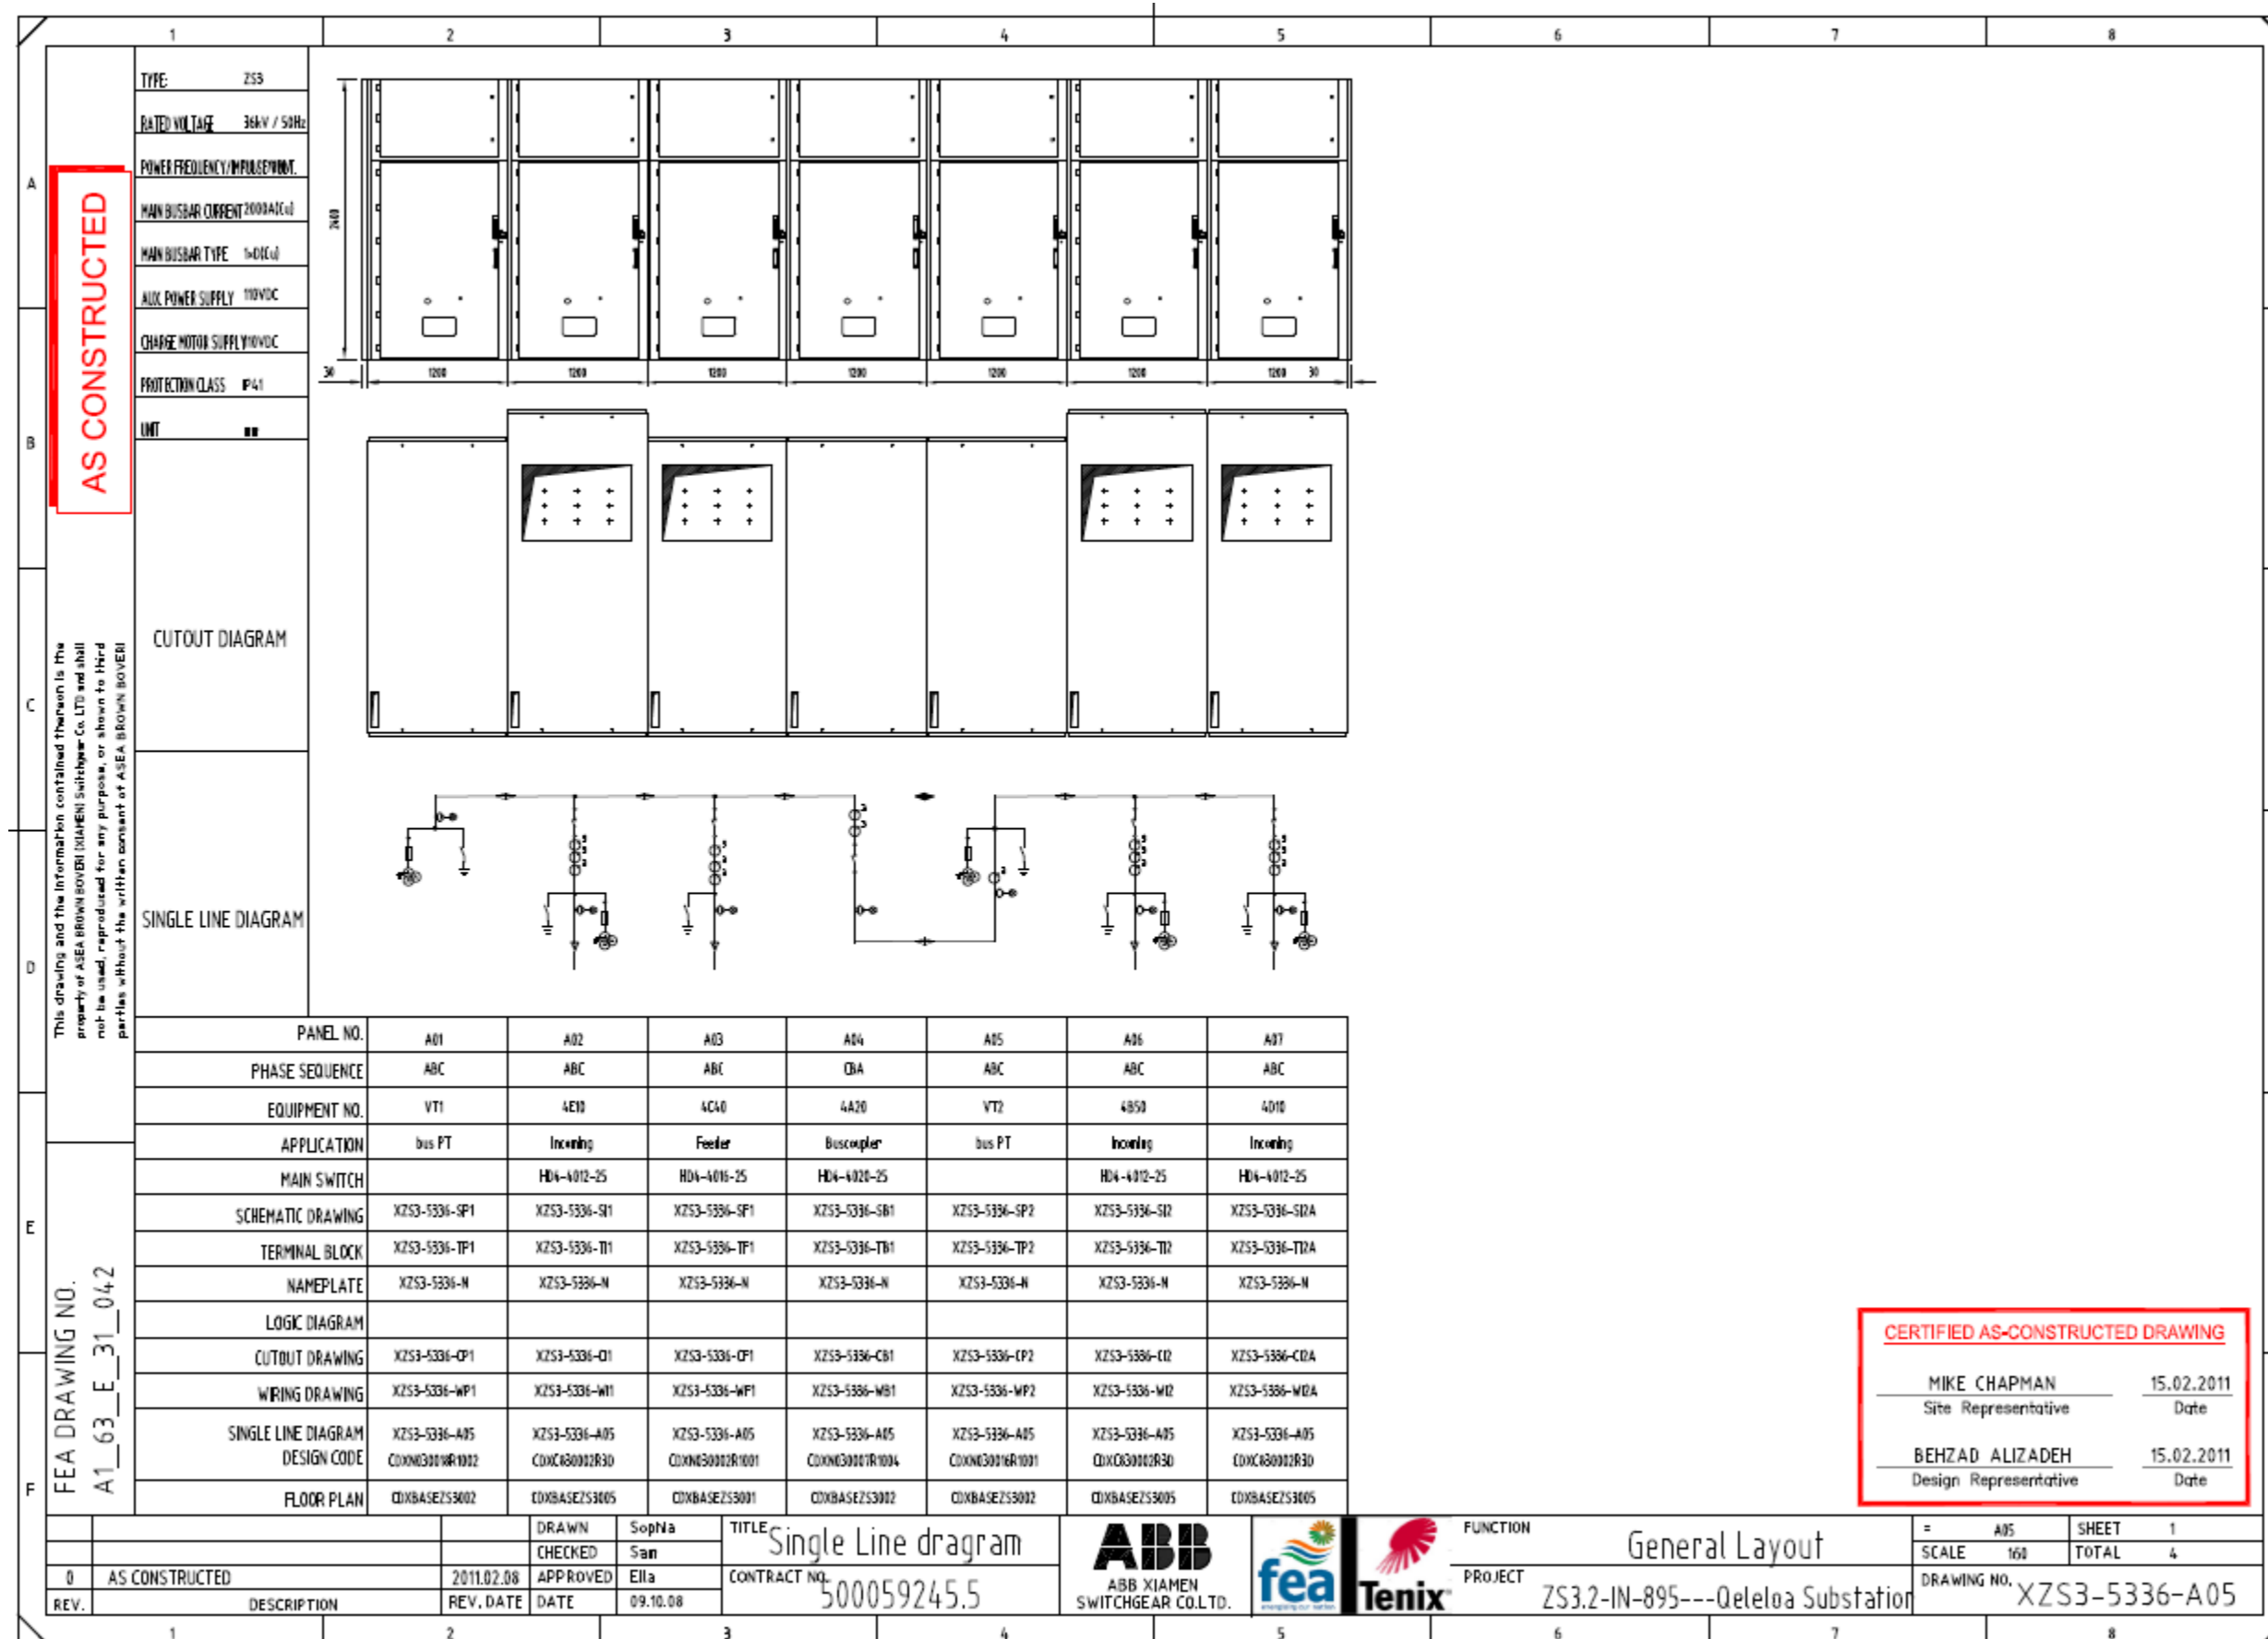

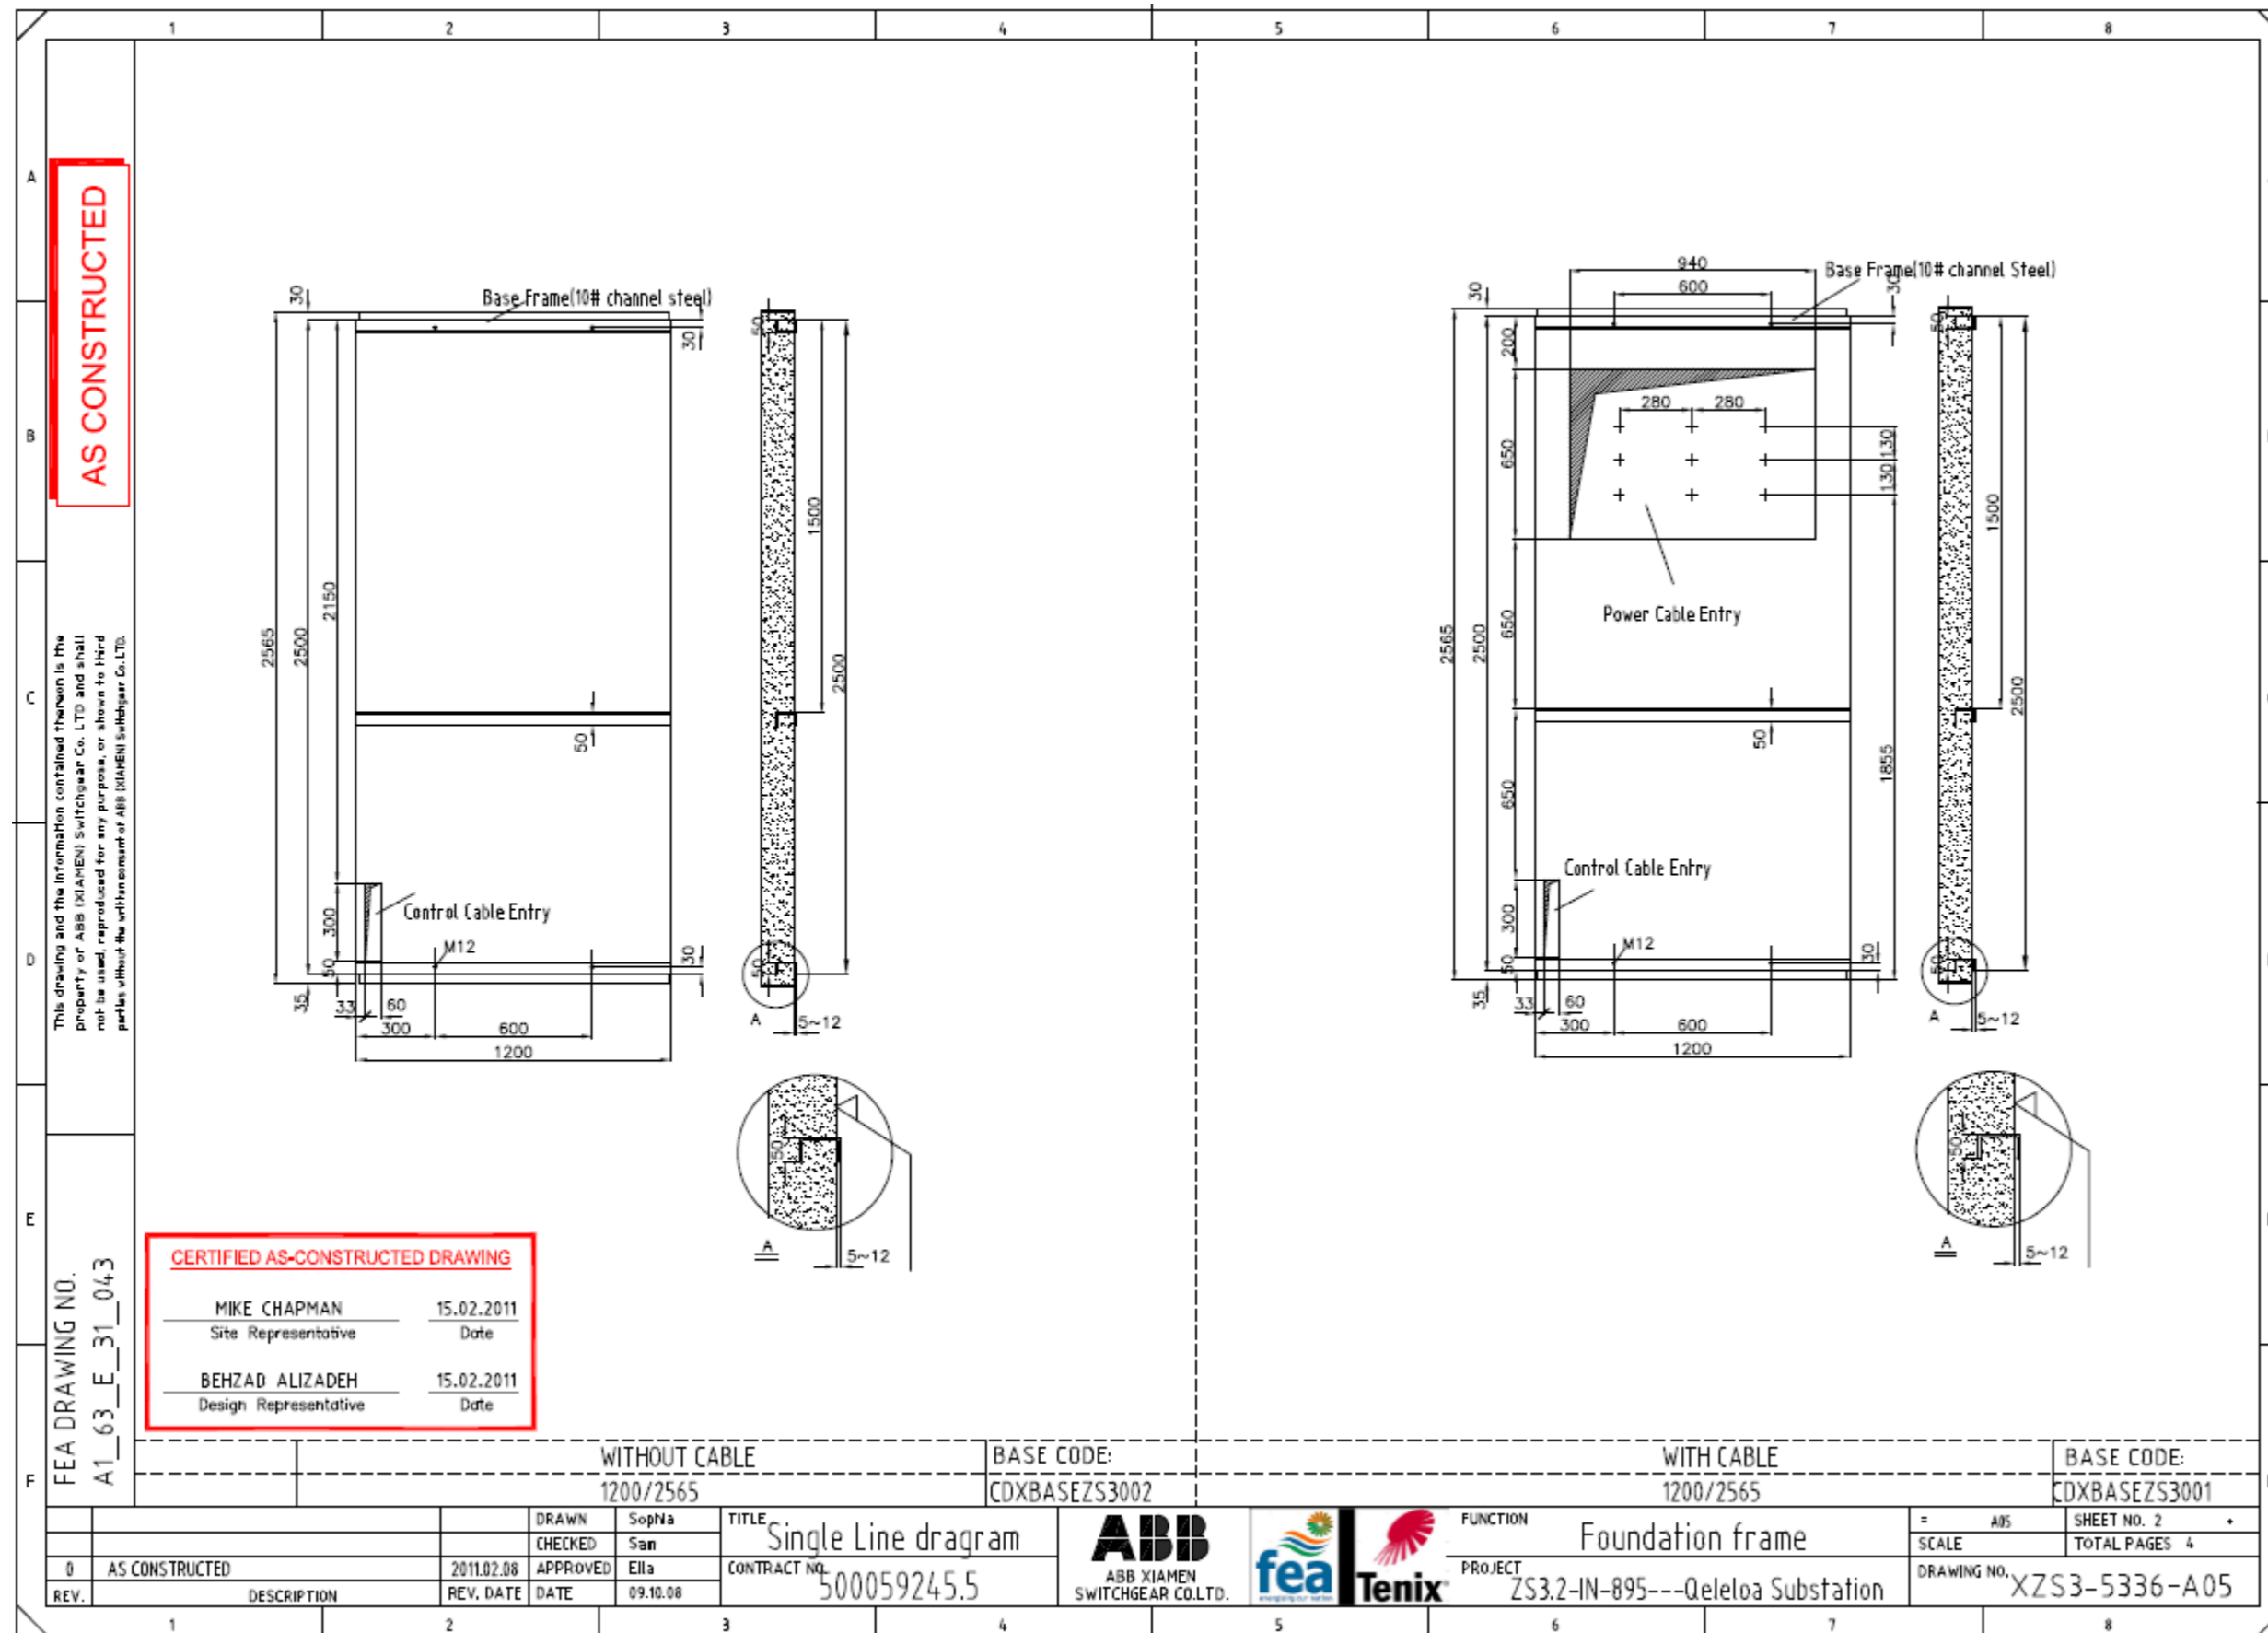


AS CONSTRUCTED

CERTIFIED AS-CONSTRUCTED DRAWING

|                       |            |
|-----------------------|------------|
| MIKE CHAPMAN          | 15.02.2011 |
| Site Representative   | Date       |
| BEHZAD ALIZADEH       | 15.02.2011 |
| Design Representative | Date       |

FEA DRAWING NO.  
A1\_63\_E\_31\_043


|      |                            |                               |                                   |                             |
|------|----------------------------|-------------------------------|-----------------------------------|-----------------------------|
|      | WITHOUT CABLE<br>1200/2565 | BASE CODE:<br>COXBASEZS3002   | WITH CABLE<br>1200/2565           | BASE CODE:<br>COXBASEZS3001 |
|      | DRAWN SopNa                | TITLE                         | FUNCTION                          | = A05 SHEET NO. 2           |
| 0    | AS CONSTRUCTED             | 2011.02.08                    | CHECKED San                       | SCALE TOTAL PAGES 4         |
| REV. | DESCRIPTION                | REV. DATE                     | DATE                              | APPROVED Ella               |
| 1    | AS CONSTRUCTED             | 2011.02.08                    | DATE                              | 09.10.08                    |
|      |                            |                               | CONTRACT NO.                      | DRAWING NO.                 |
|      |                            |                               | 500059245.5                       | XZS3-5336-A05               |
|      |                            | ABB                           | PROJECT                           |                             |
|      |                            | ABB XIAMEN SWITCHGEAR CO.LTD. | ZS3.2-IN-895---Qeleloa Substation |                             |

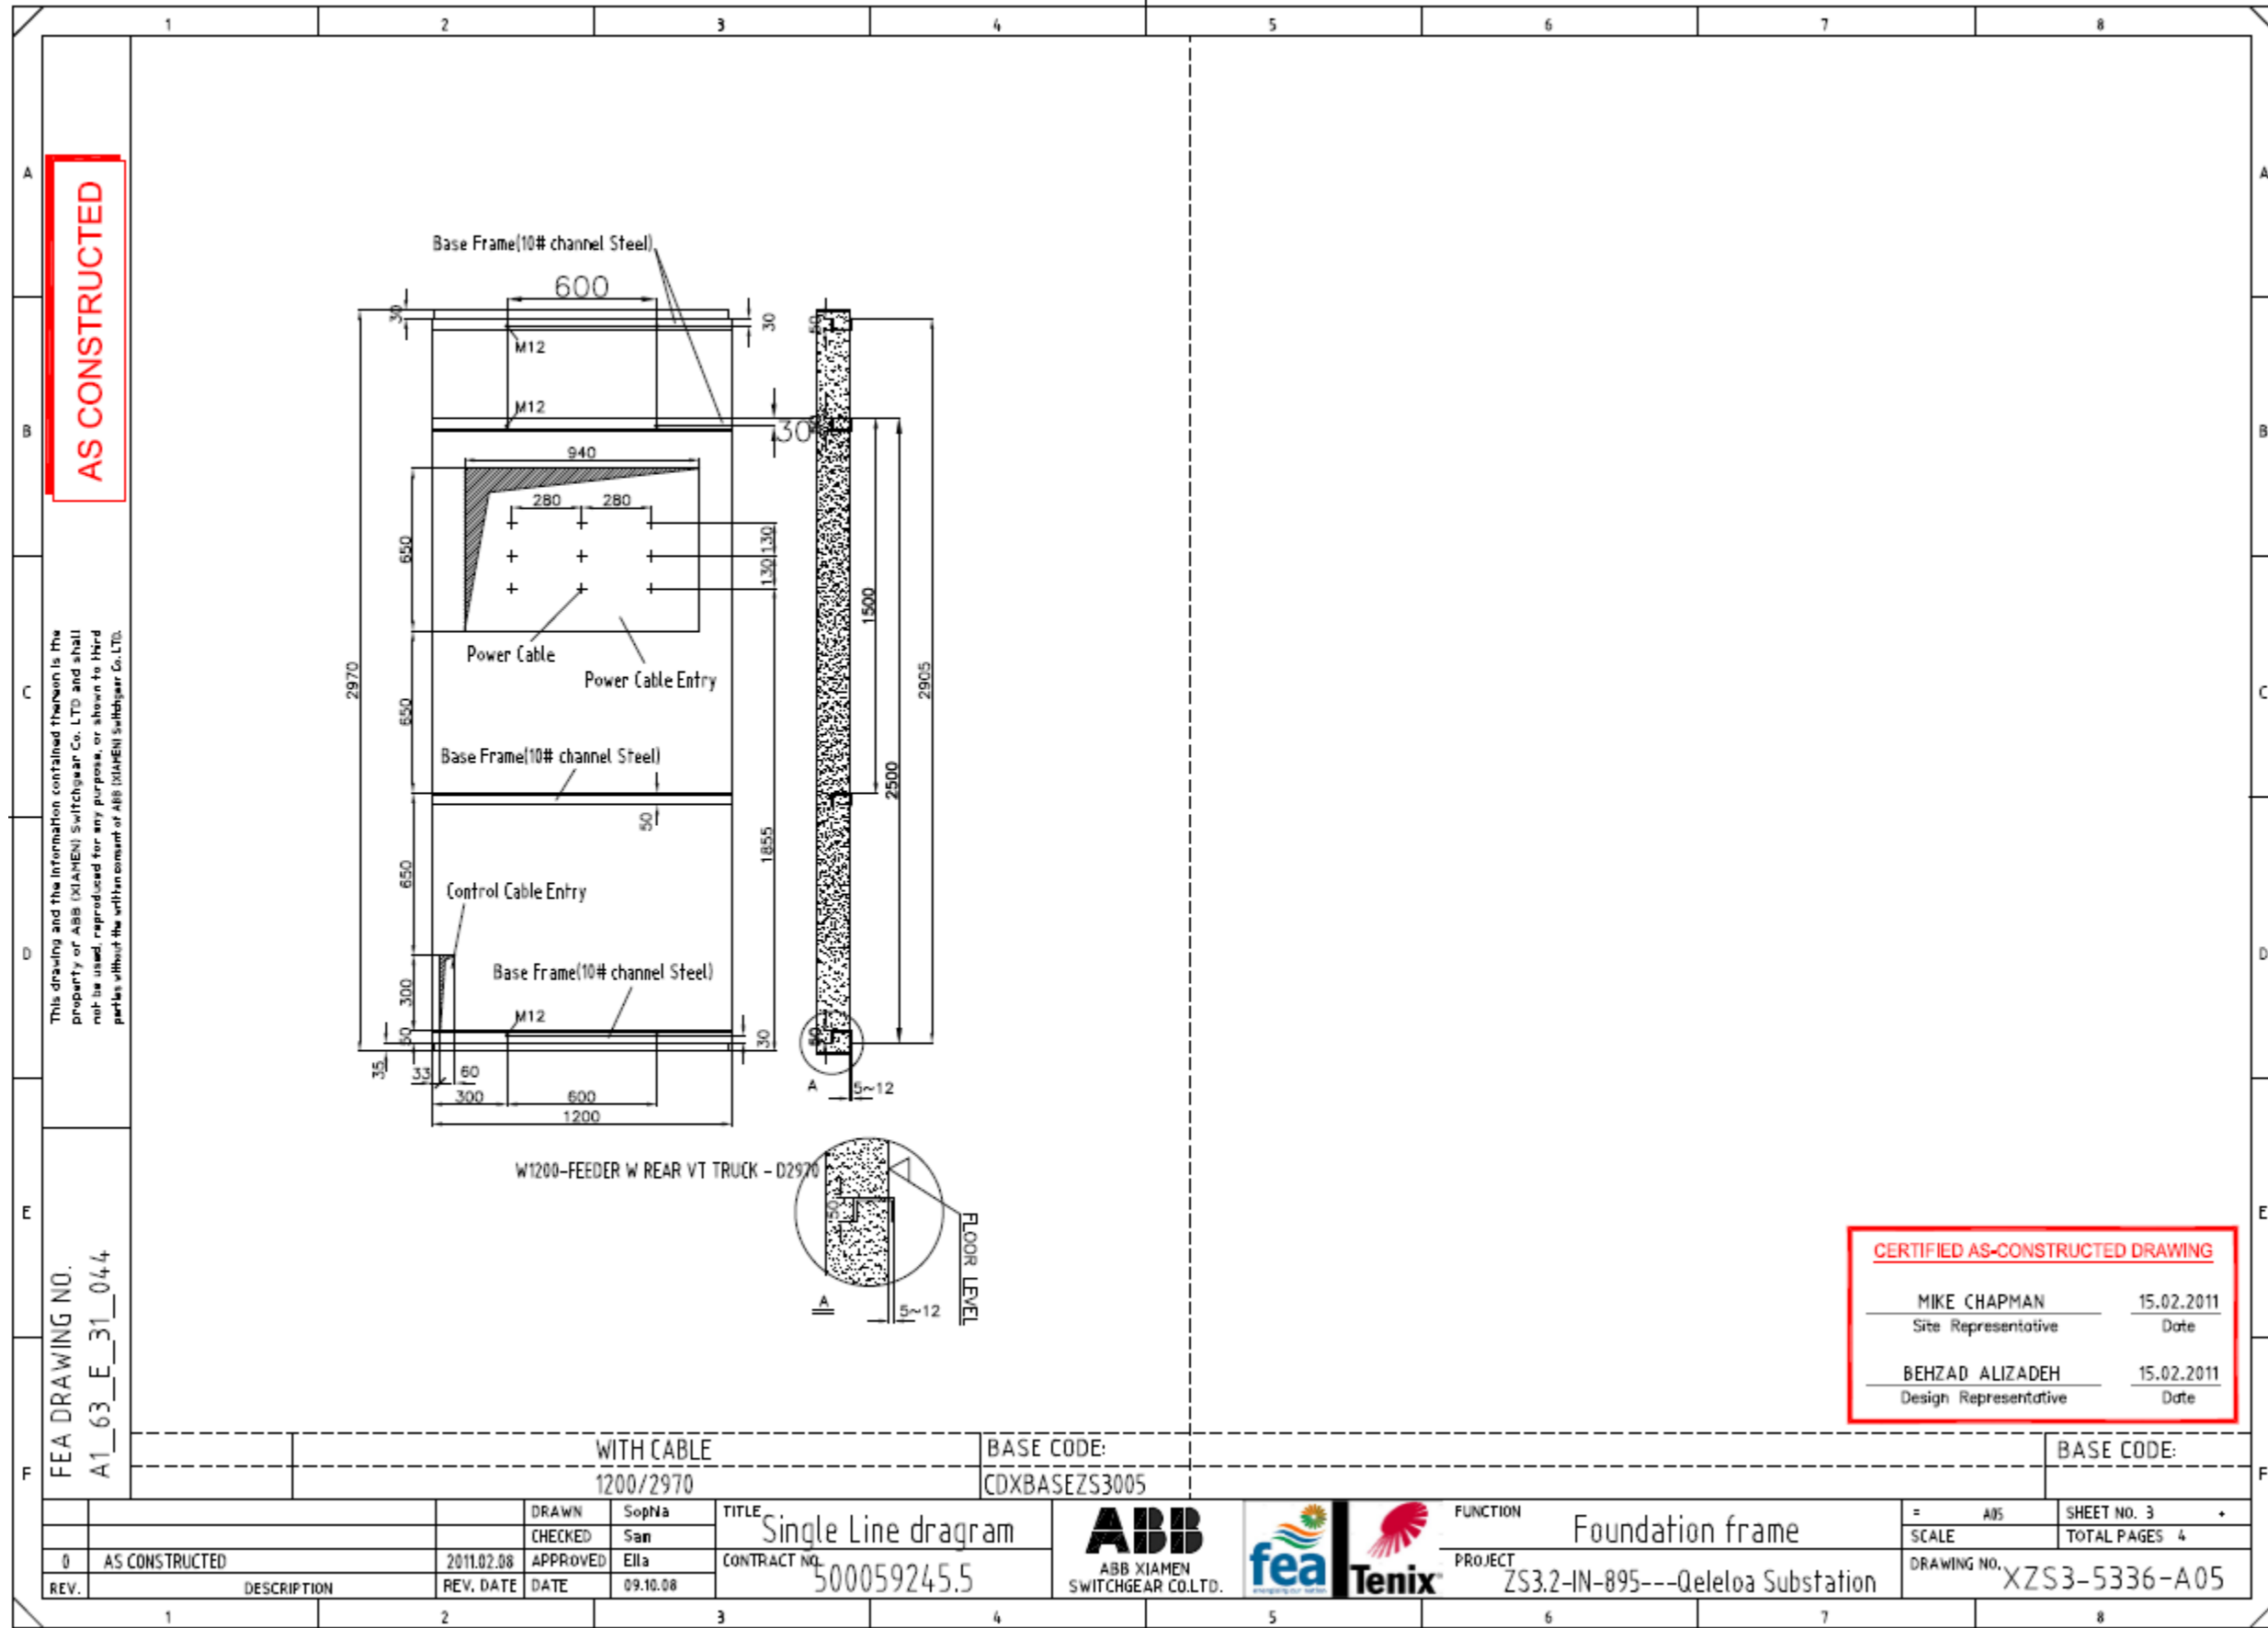

FEA DRAWING NO.  
A1\_63\_E\_31\_044

WITH CABLE      BASE CODE:      BASE CODE:  
1200/2970      CDXBASEZS3005

|      |             |           |      |             |             |               |                               |                             |                                      |              |                              |  |                              |             |               |
|------|-------------|-----------|------|-------------|-------------|---------------|-------------------------------|-----------------------------|--------------------------------------|--------------|------------------------------|--|------------------------------|-------------|---------------|
| REV. | DESCRIPTION | REV. DATE | DATE | DRAWN SopNa | CHECKED San | APPROVED Ella | TITLES<br>Single Line diagram | CONTRACT NO.<br>500059245.5 | ABB<br>ABB XIAMEN SWITCHGEAR CO.LTD. | fea<br>Tenix | FUNCTION<br>Foundation frame | PROJECT<br>ZS3.2-IN-895---Qeleloa Substation | DRAWING NO.<br>XZS3-5336-A05 | SHEET NO. 3 | TOTAL PAGES 4 |
|------|-------------|-----------|------|-------------|-------------|---------------|-------------------------------|-----------------------------|--------------------------------------|--------------|------------------------------|--|------------------------------|-------------|---------------|

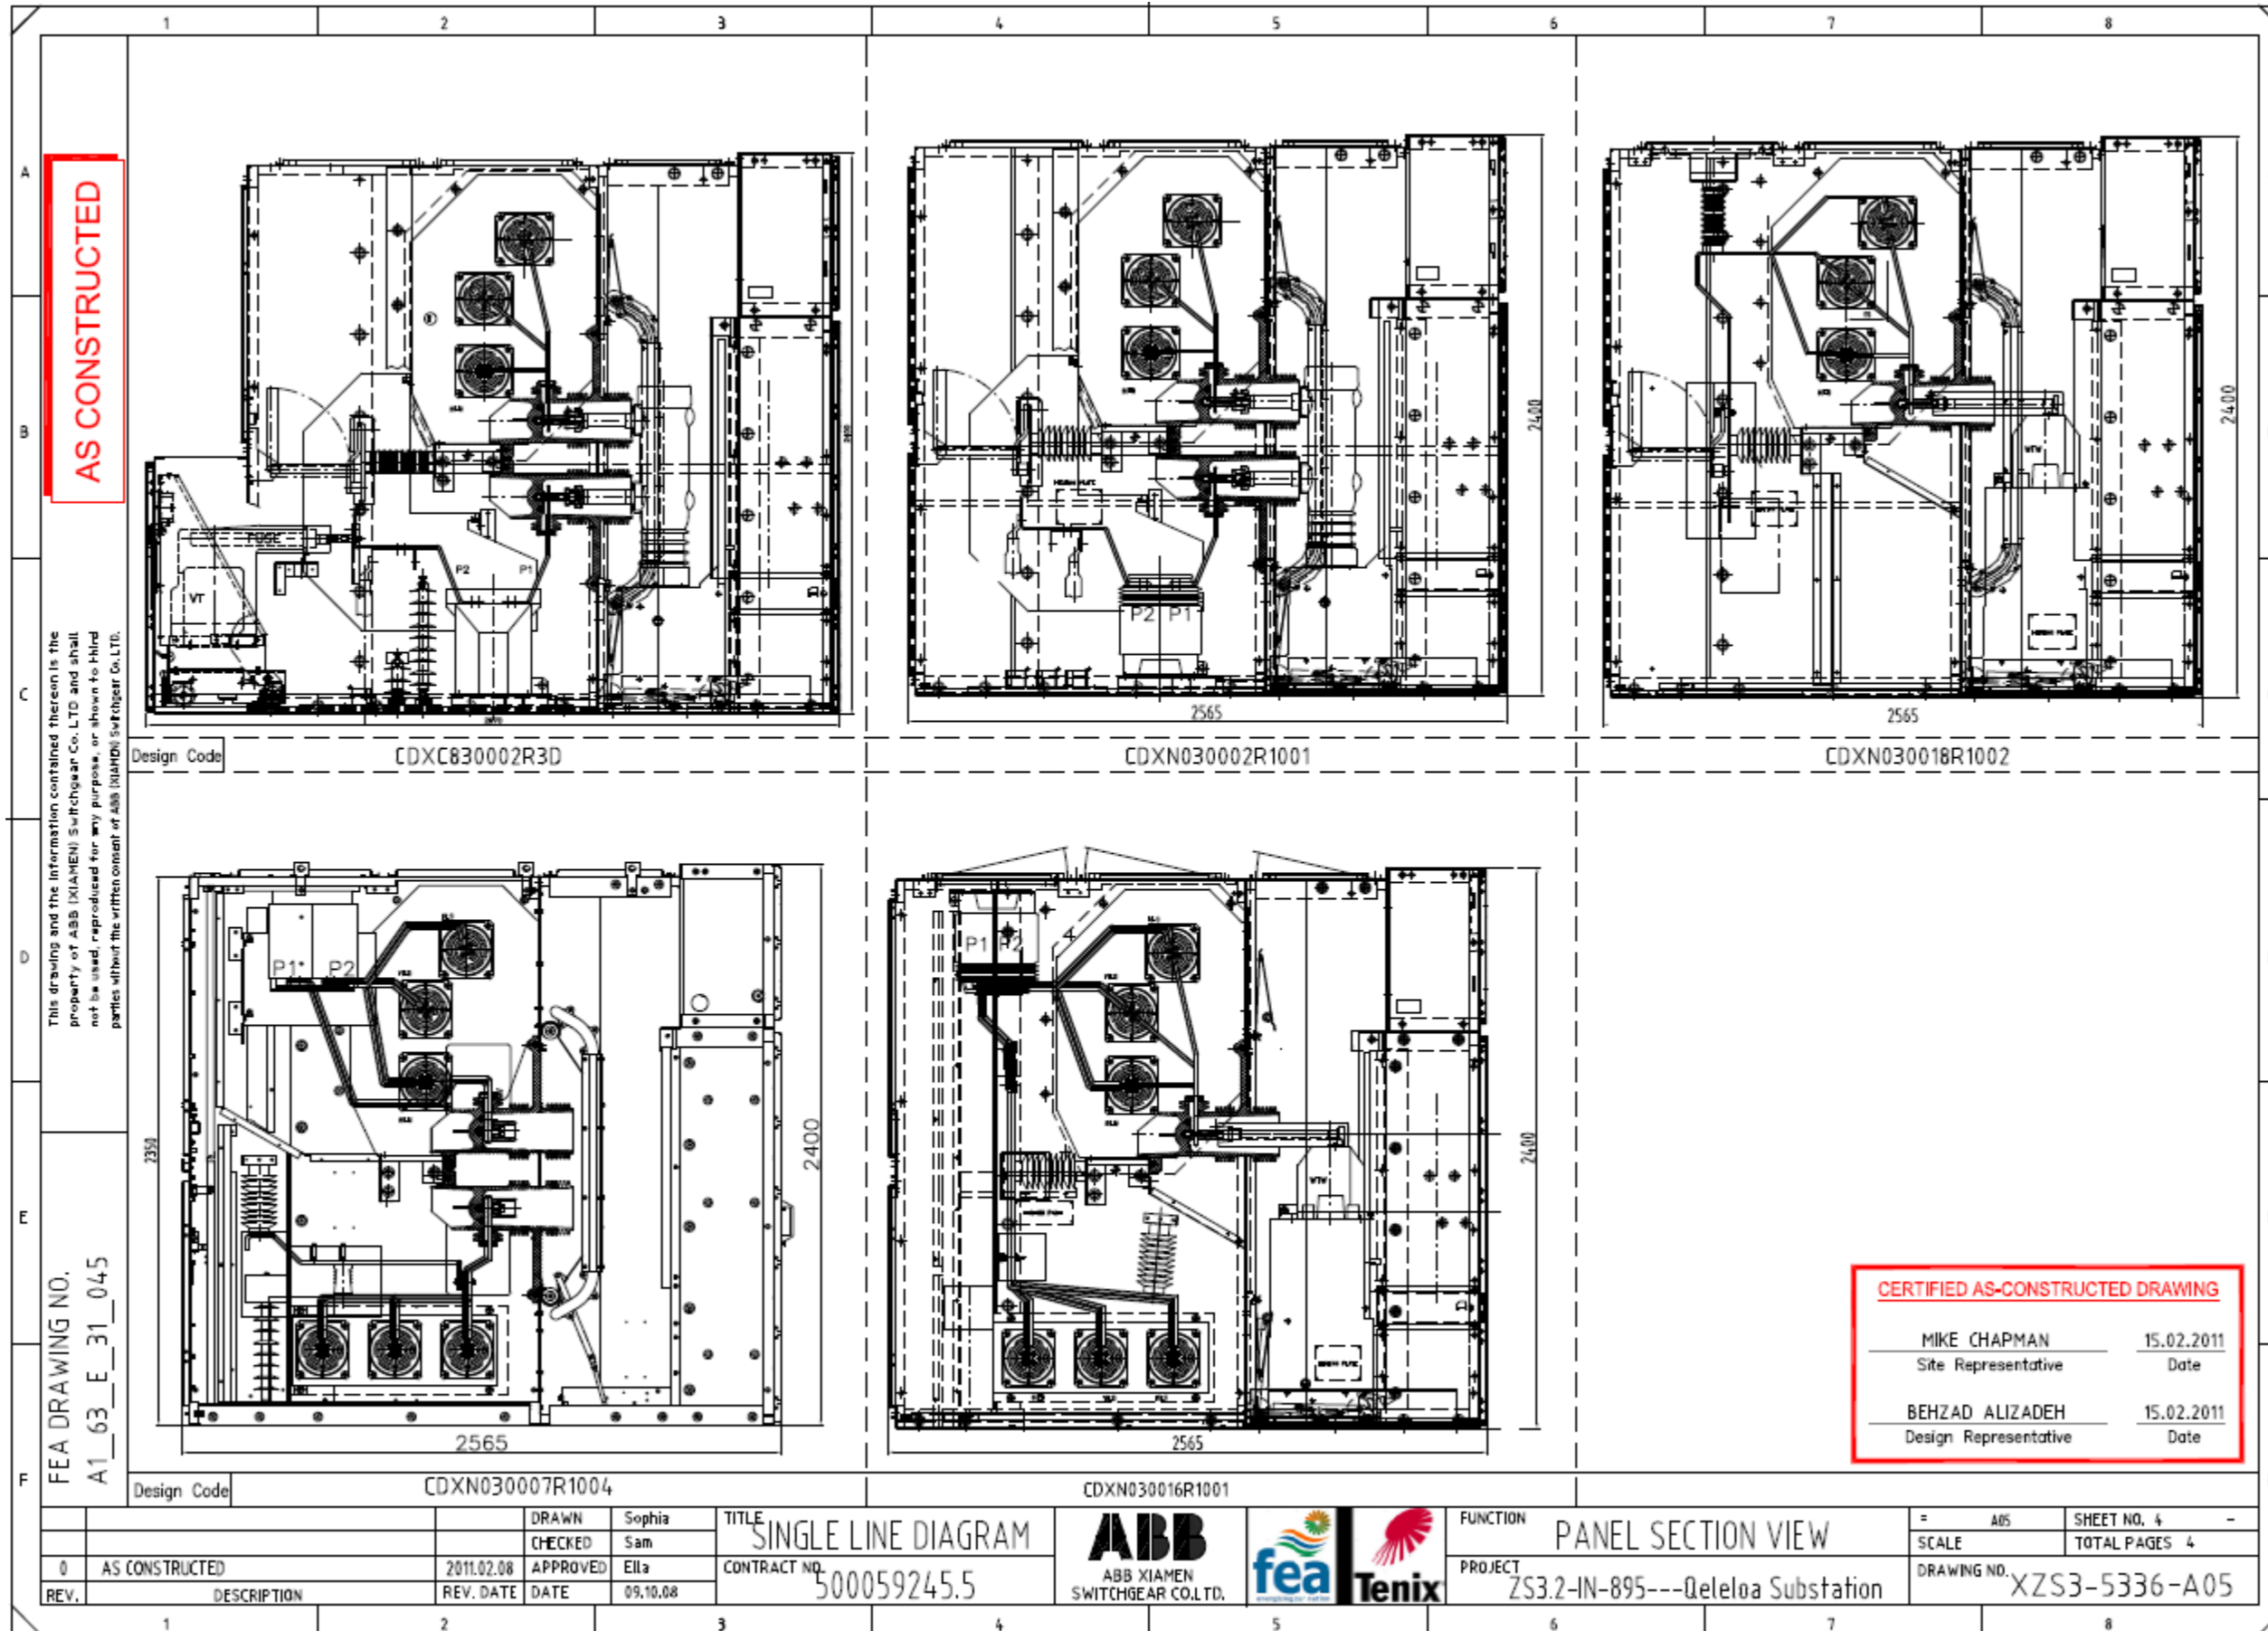



APPENDIX 2

